
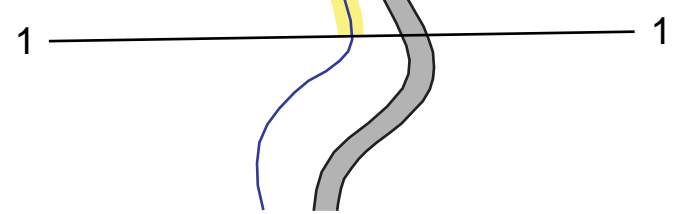



**EXPLANATION**  
**LITHOLOGY**

Age	Color	Description
<b>Surficial units:</b>		
Soils		Unified Soil Classification symbols used throughout, e.g. "CL/CH"
Recent		<b>Asphalt (road) or concrete.</b>
Recent	Qf	<b>Fill.</b> Engineered and non-engineered fill emplaced during realignment of creek channel.
Holocene	Qs	<b>Bedded silt.</b> Low to moderate plasticity (ML), well bedded.
Holocene	Qt	<b>Terrace deposits.</b> Well- poorly graded gravel, and sand/gravel mixtures deposited in ancestral and recent stream channel.
Pleistocene-Holocene	Qc	<b>Colluvium.</b> Massive, highly plastic, clayey silt with fragments of bedrock units. Landslide and debris flow deposits.
<b>Bedrock units:</b>		
Tertiary	Ts	<b>Sedimentary rock.</b> Well bedded to massive, friable, sandstone, mudstone, and shale of the Lambert Shale, and San Lorenzo and Purisma Formations.
Tertiary	Tb	<b>Basalt.</b> Fractured, weathered lava flows and shallow intrusives of the Mindego Basalt. Veins of calcite and quartz.

**SYMBOLS**

- Active landslide. Borders and fill indicate lithologic unit exposed.
- Stratigraphic sequence in channel bank. Example indicates colluvium over basalt.
- Gabion wall.
- Sackrete wall.
- Large woody debris (LWD).
- Culvert.
- House.
- Rip rap revetment.
- Concrete wall.
- Geogrid.
- Bridge or crossing.

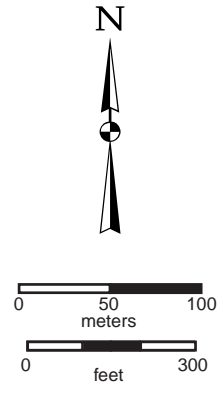

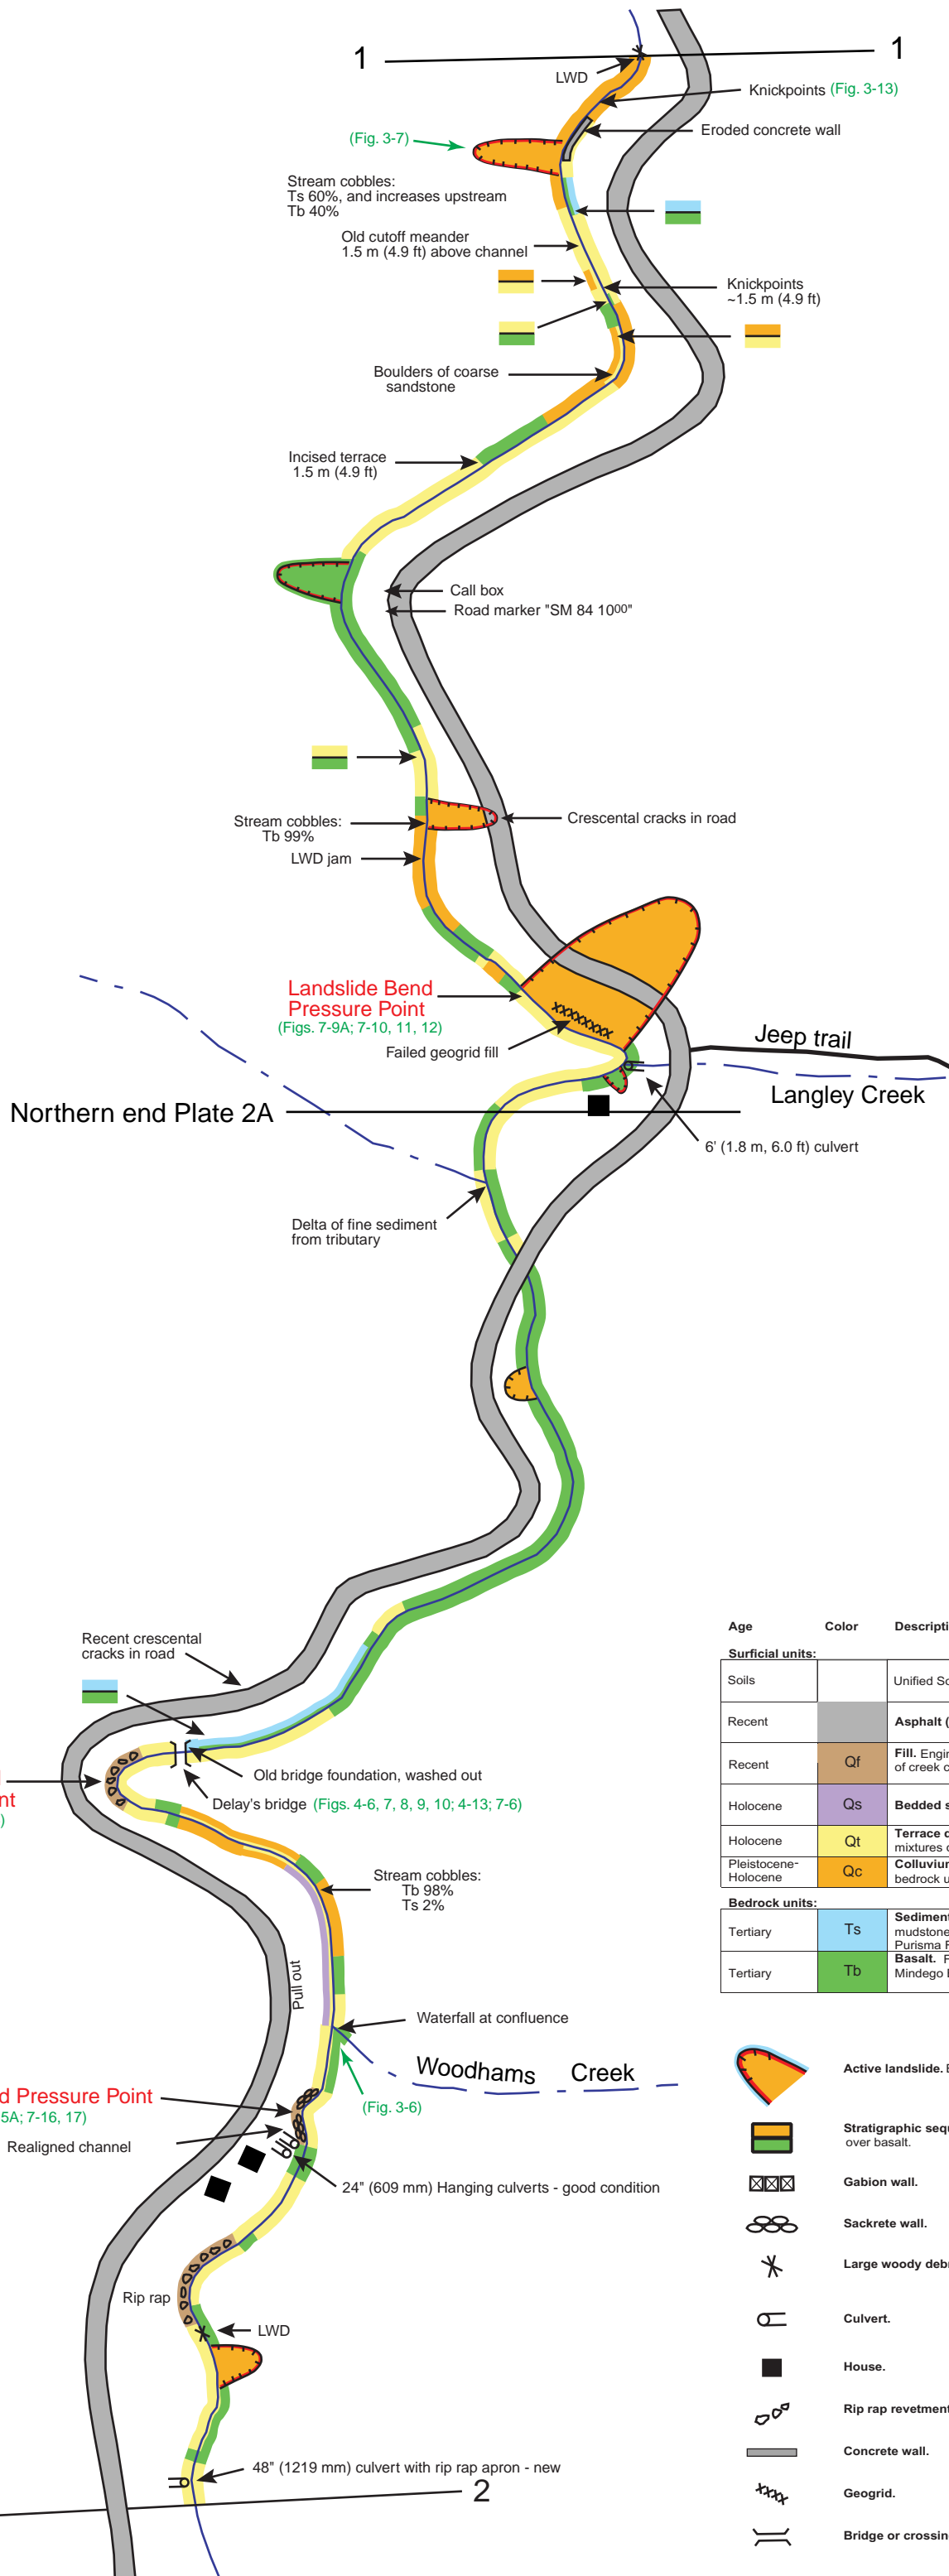

EXPLANATION

LITHOLOGY

Age	Color	Description
<b>Surficial units:</b>		
Soils		Unified Soil Classification symbols used throughout, e.g. "CL/CH"
Recent		Asphalt (road) or concrete.
Recent	Qf	Fill. Engineered and non-engineered fill emplaced during realignment of creek channel.
Holocene	Qs	Bedded silt. Low to moderate plasticity (ML), well bedded.
Holocene	Qt	Terrace deposits. Well- poorly graded gravel, and sand/gravel mixtures deposited in ancestral and recent stream channel.
Pleistocene-Holocene	Qc	Colluvium. Massive, highly plastic, clayey silt with fragments of bedrock units. Landslide and debris flow deposits.
<b>Bedrock units:</b>		
Tertiary	Ts	Sedimentary rock. Well bedded to massive, friable, sandstone, mudstone, and shale of the Lambert Shale, and San Lorenzo and Purisma Formations.
Tertiary	Tb	Basalt. Fractured, weathered lava flows and shallow intrusives of the Mindego Basalt. Veins of calcite and quartz.

SYMBOLS












- Active landslide. Borders and fill indicate lithologic unit exposed.
- Stratigraphic sequence in channel bank. Example indicates colluvium over basalt.
- Gabion wall.
- Sackrete wall.
- Large woody debris (LWD).
- Culvert.
- House.
- Rip rap revetment.
- Concrete wall.
- Geogrid.
- Bridge or crossing.



EXPLANATION

LITHOLOGY




Age	Color	Description
<b>Surficial units:</b>		
Soils		Unified Soil Classification symbols used throughout, e.g. "CL/CH"
Recent		<b>Asphalt (road) or concrete.</b>
Recent	Qf	<b>Fill.</b> Engineered and non-engineered fill emplaced during realignment of creek channel.
Holocene	Qs	<b>Bedded silt.</b> Low to moderate plasticity (ML), well bedded.
Holocene	Qt	<b>Terrace deposits.</b> Well- poorly graded gravel, and sand/gravel mixtures deposited in ancestral and recent stream channel.
Pleistocene-Holocene	Qc	<b>Colluvium.</b> Massive, highly plastic, clayey silt with fragments of bedrock units. Landslide and debris flow deposits.
<b>Bedrock units:</b>		
Tertiary	Ts	<b>Sedimentary rock.</b> Well bedded to massive, friable, sandstone, mudstone, and shale of the Lambert Shale, and San Lorenzo and Purisma Formations.
Tertiary	Tb	<b>Basalt.</b> Fractured, weathered lava flows and shallow intrusives of the Mindego Basalt. Veins of calcite and quartz.

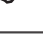SYMBOLS

-  **Active landslide.** Borders and fill indicate lithologic unit exposed.
-  **Stratigraphic sequence in channel bank.** Example indicates colluvium over basalt.
-  **Gabion wall.**
-  **Sackrete wall.**
-  **Large woody debris (LWD).**
-  **Culvert.**
-  **House.**
-  **Rip rap revetment.**
-  **Concrete wall.**
-  **Geogrid.**
-  **Bridge or crossing.**


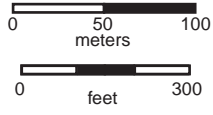
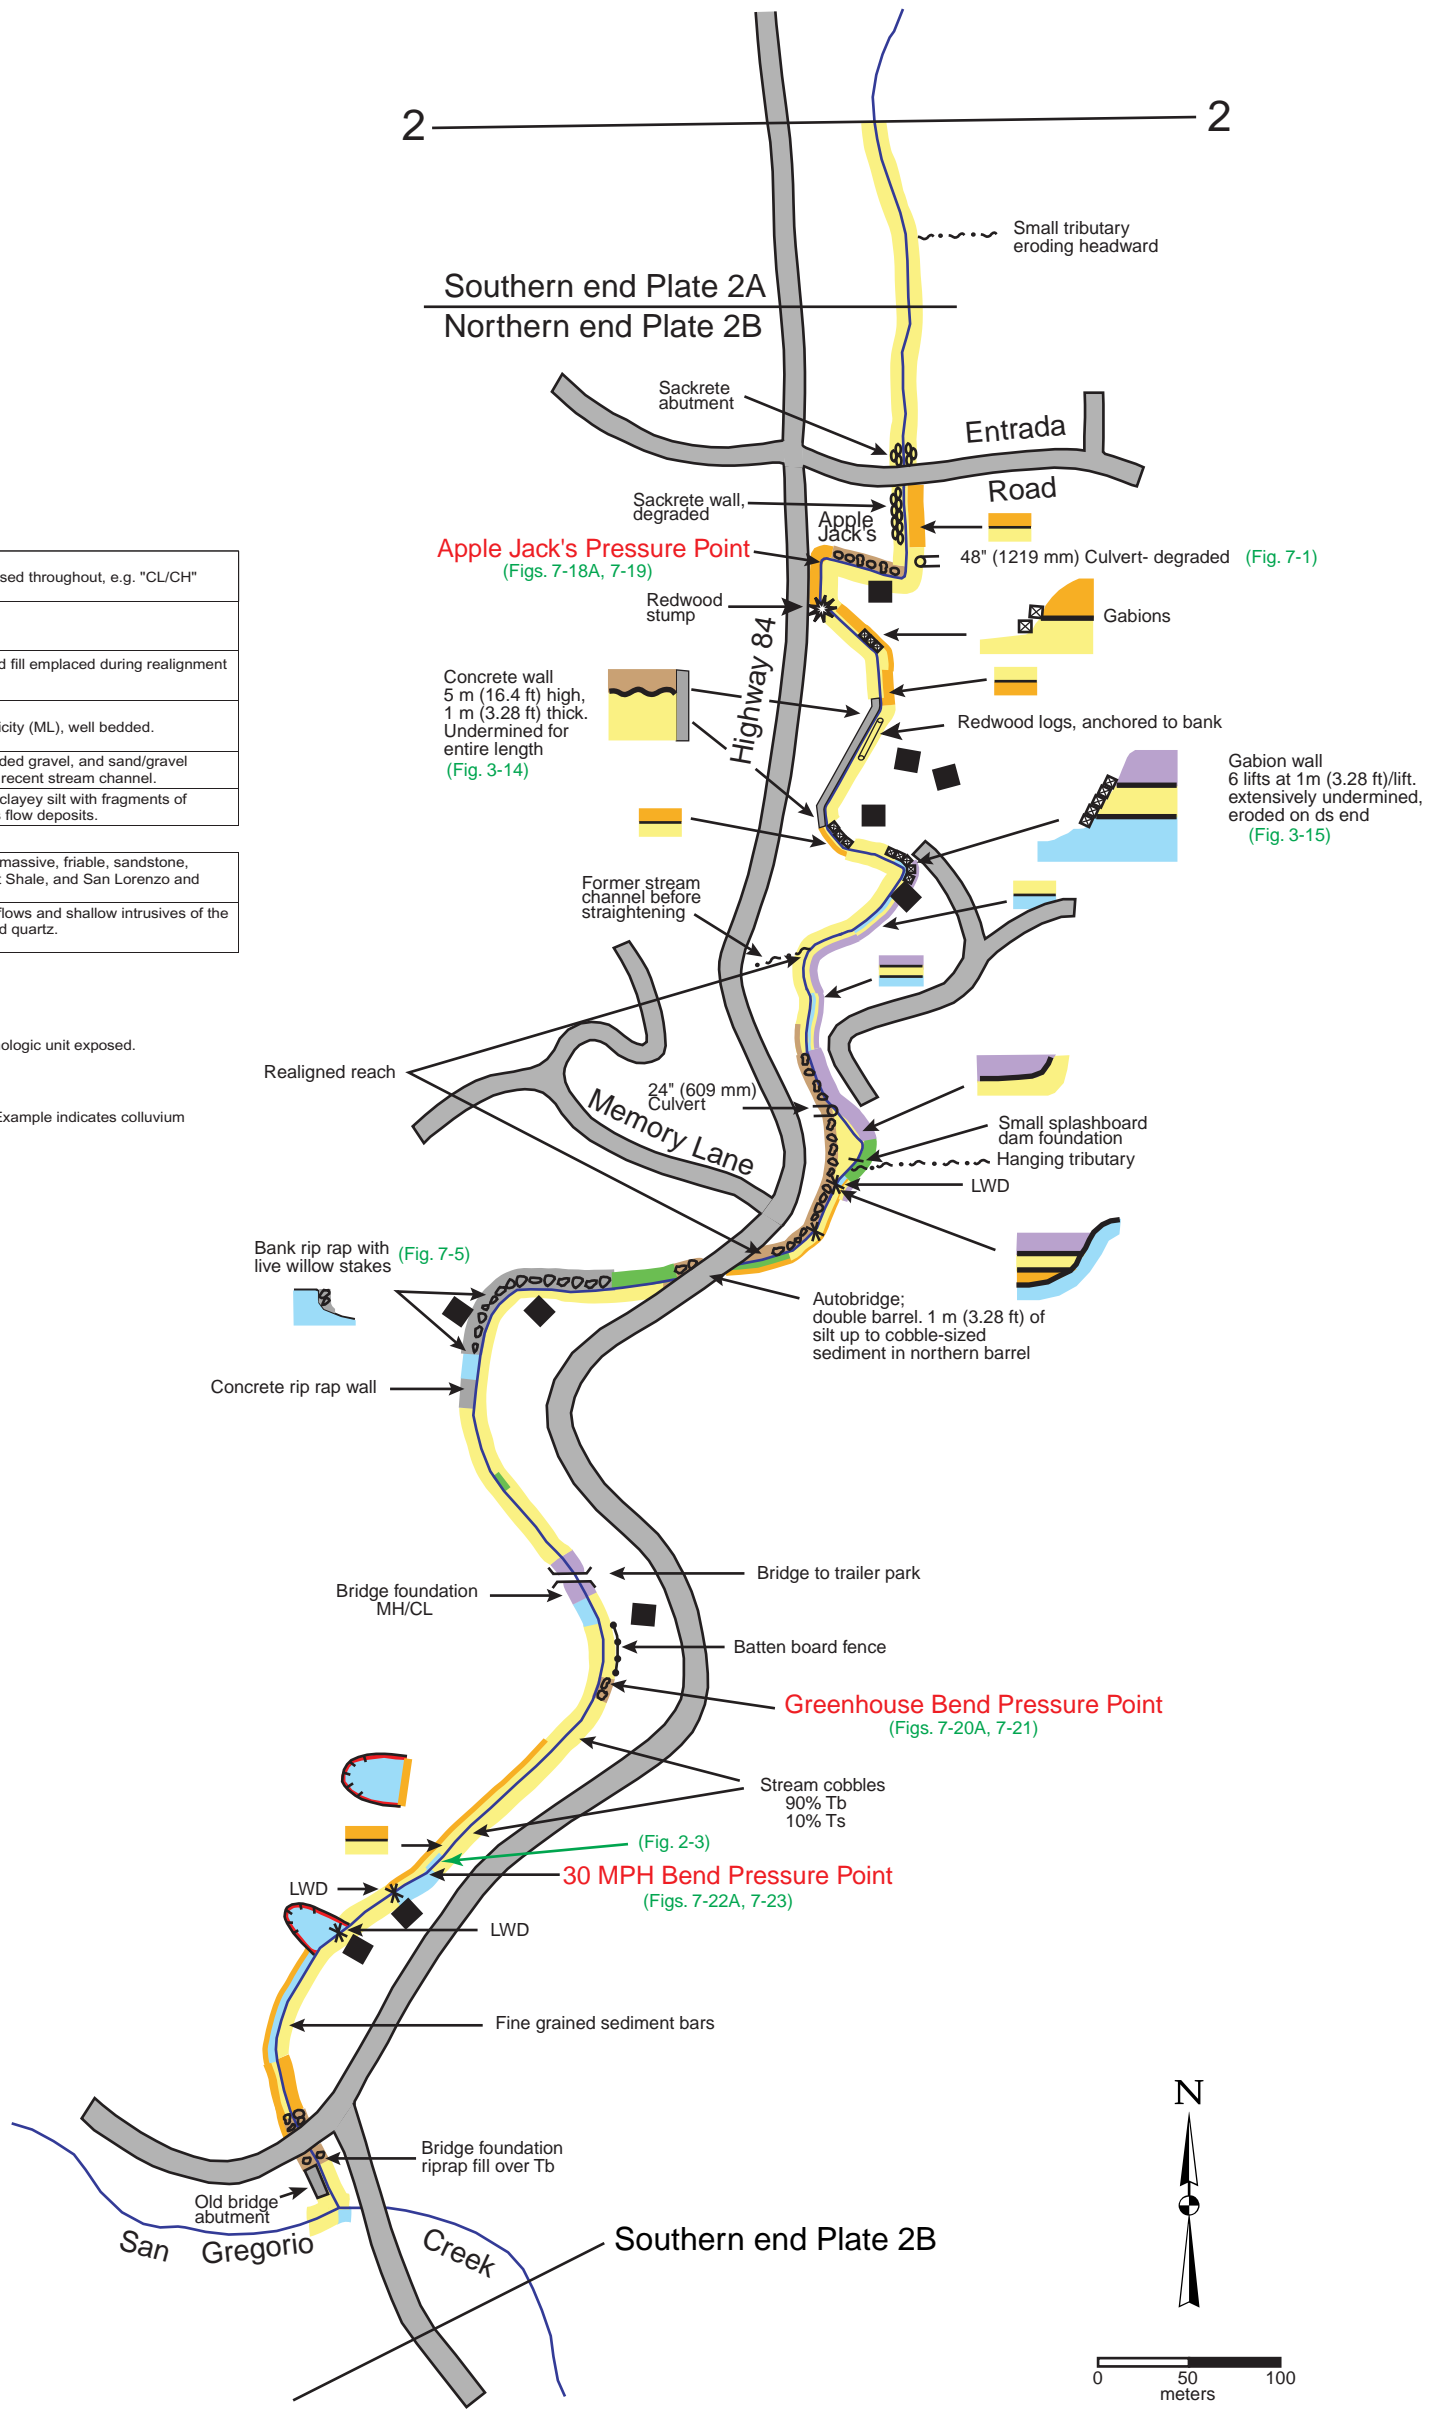


HISTORICAL AS BUILT MAP  
OF THE LA HONDA CREEK  
CHANNEL,  
SAN MATEO COUNTY, CALIFORNIA  
(Northern sheet)  
from 1954 and 1955 San Mateo  
County road construction  
project as built

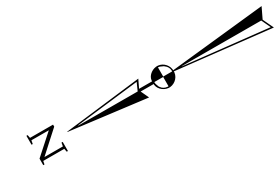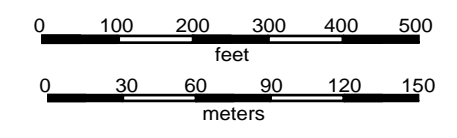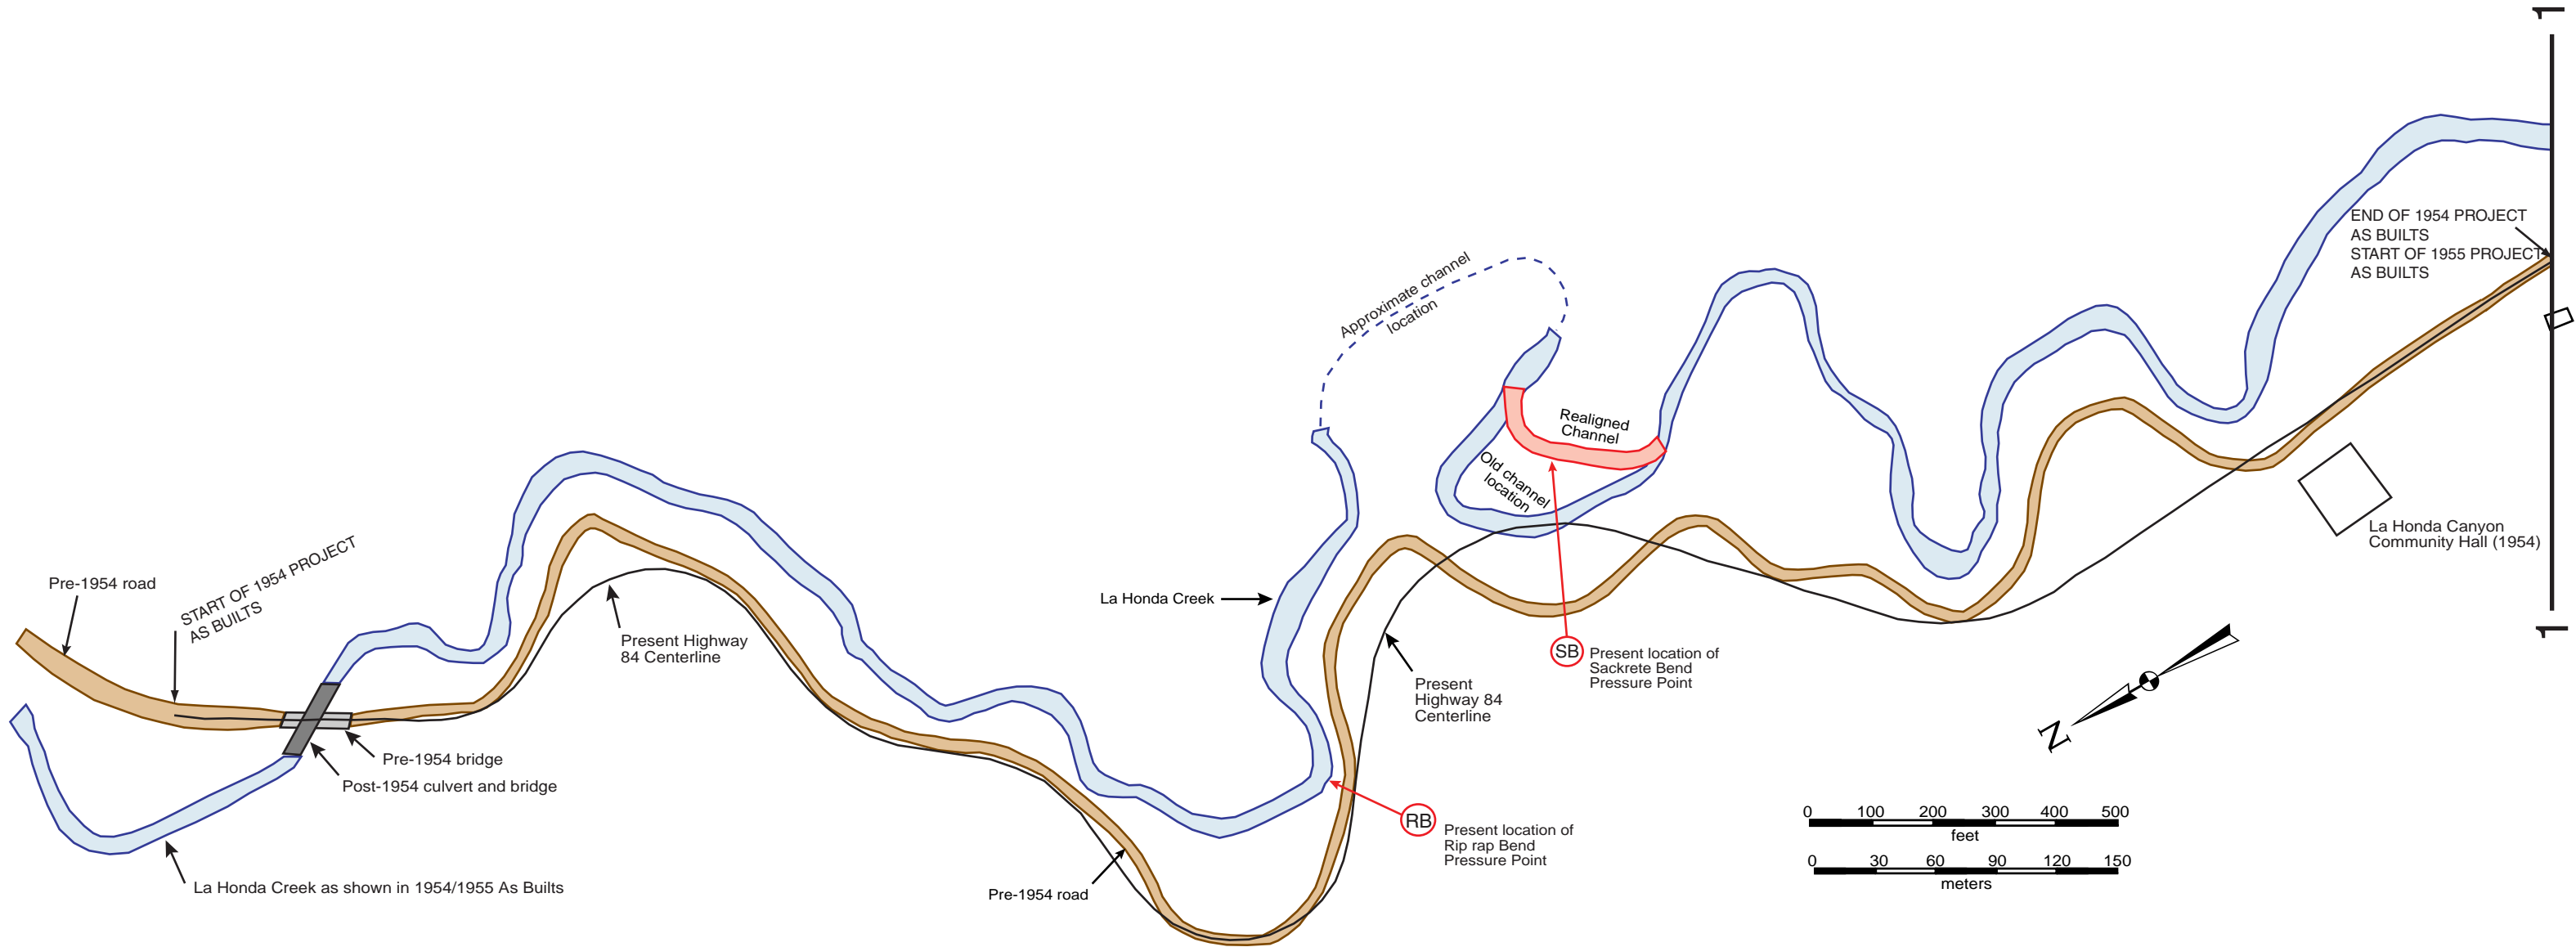

San Mateo County Road Construction  
as built on file in the Caltrans office,  
Oakland, California.  
1954 As built, File number 1656  
SM 107-A  
1955 As built, File number 1744-1  
SM 107-A (MP 8.84)

HISTORICAL AS BUILT MAP  
 OF THE LA HONDA CREEK  
 CHANNEL,  
 SAN MATEO COUNTY, CALIFORNIA  
 (Southern sheet)  
 from 1954 and 1955 San Mateo  
 County road construction  
 project as built

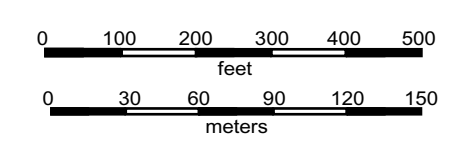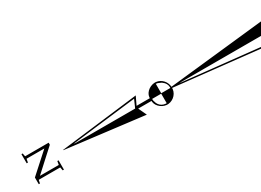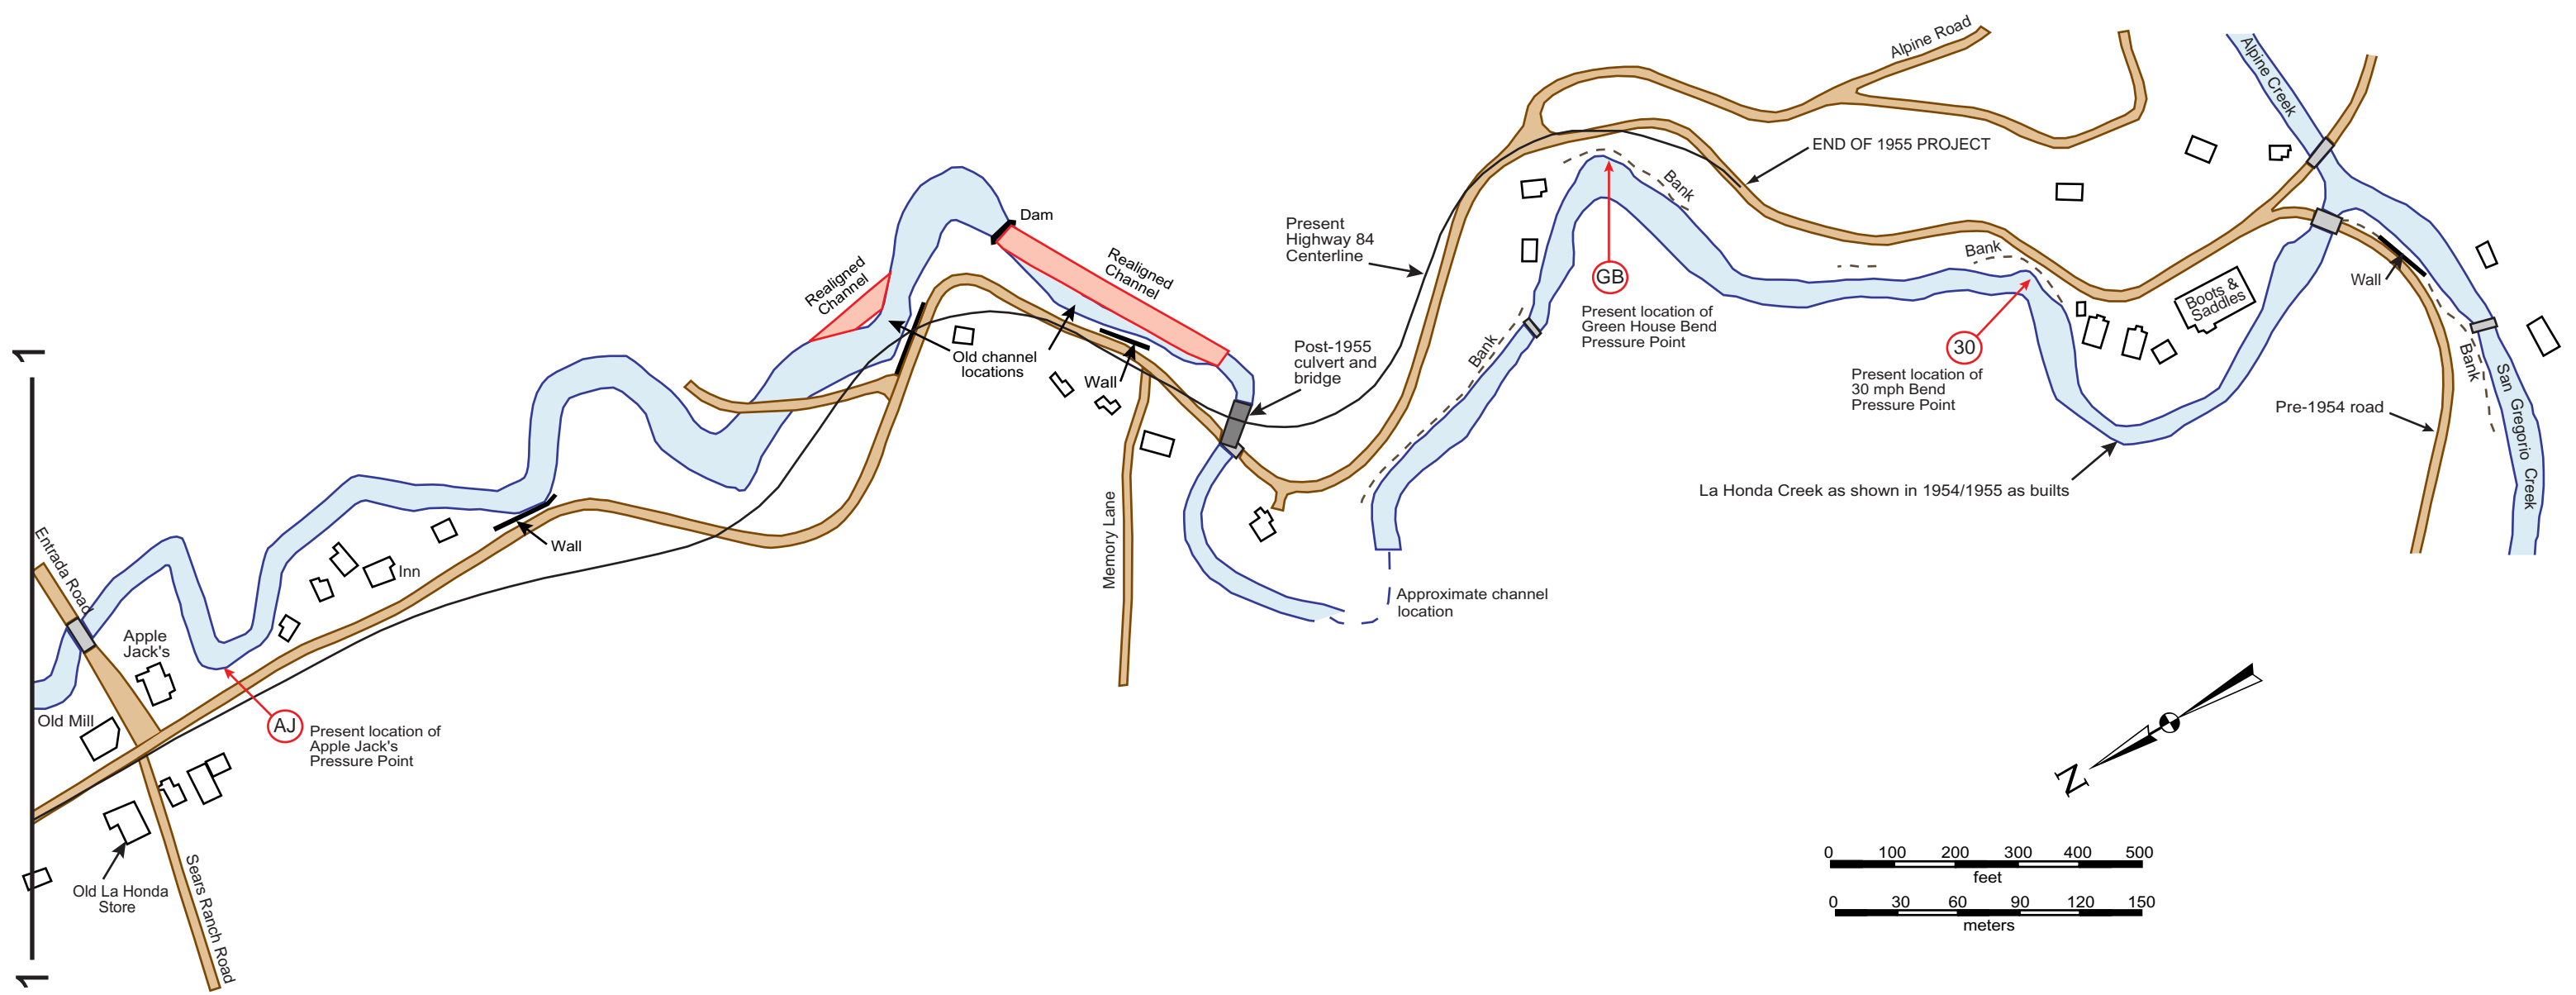

San Mateo County Road Construction  
 as built on file in the Caltrans office,  
 Oakland, California.  
 1954 As built, File number 1656  
 SM 107-A  
 1955 As built, File number 1744-1  
 SM 107-A (MP 8.84)